


ABC BUILDING - MAIN FLOOR

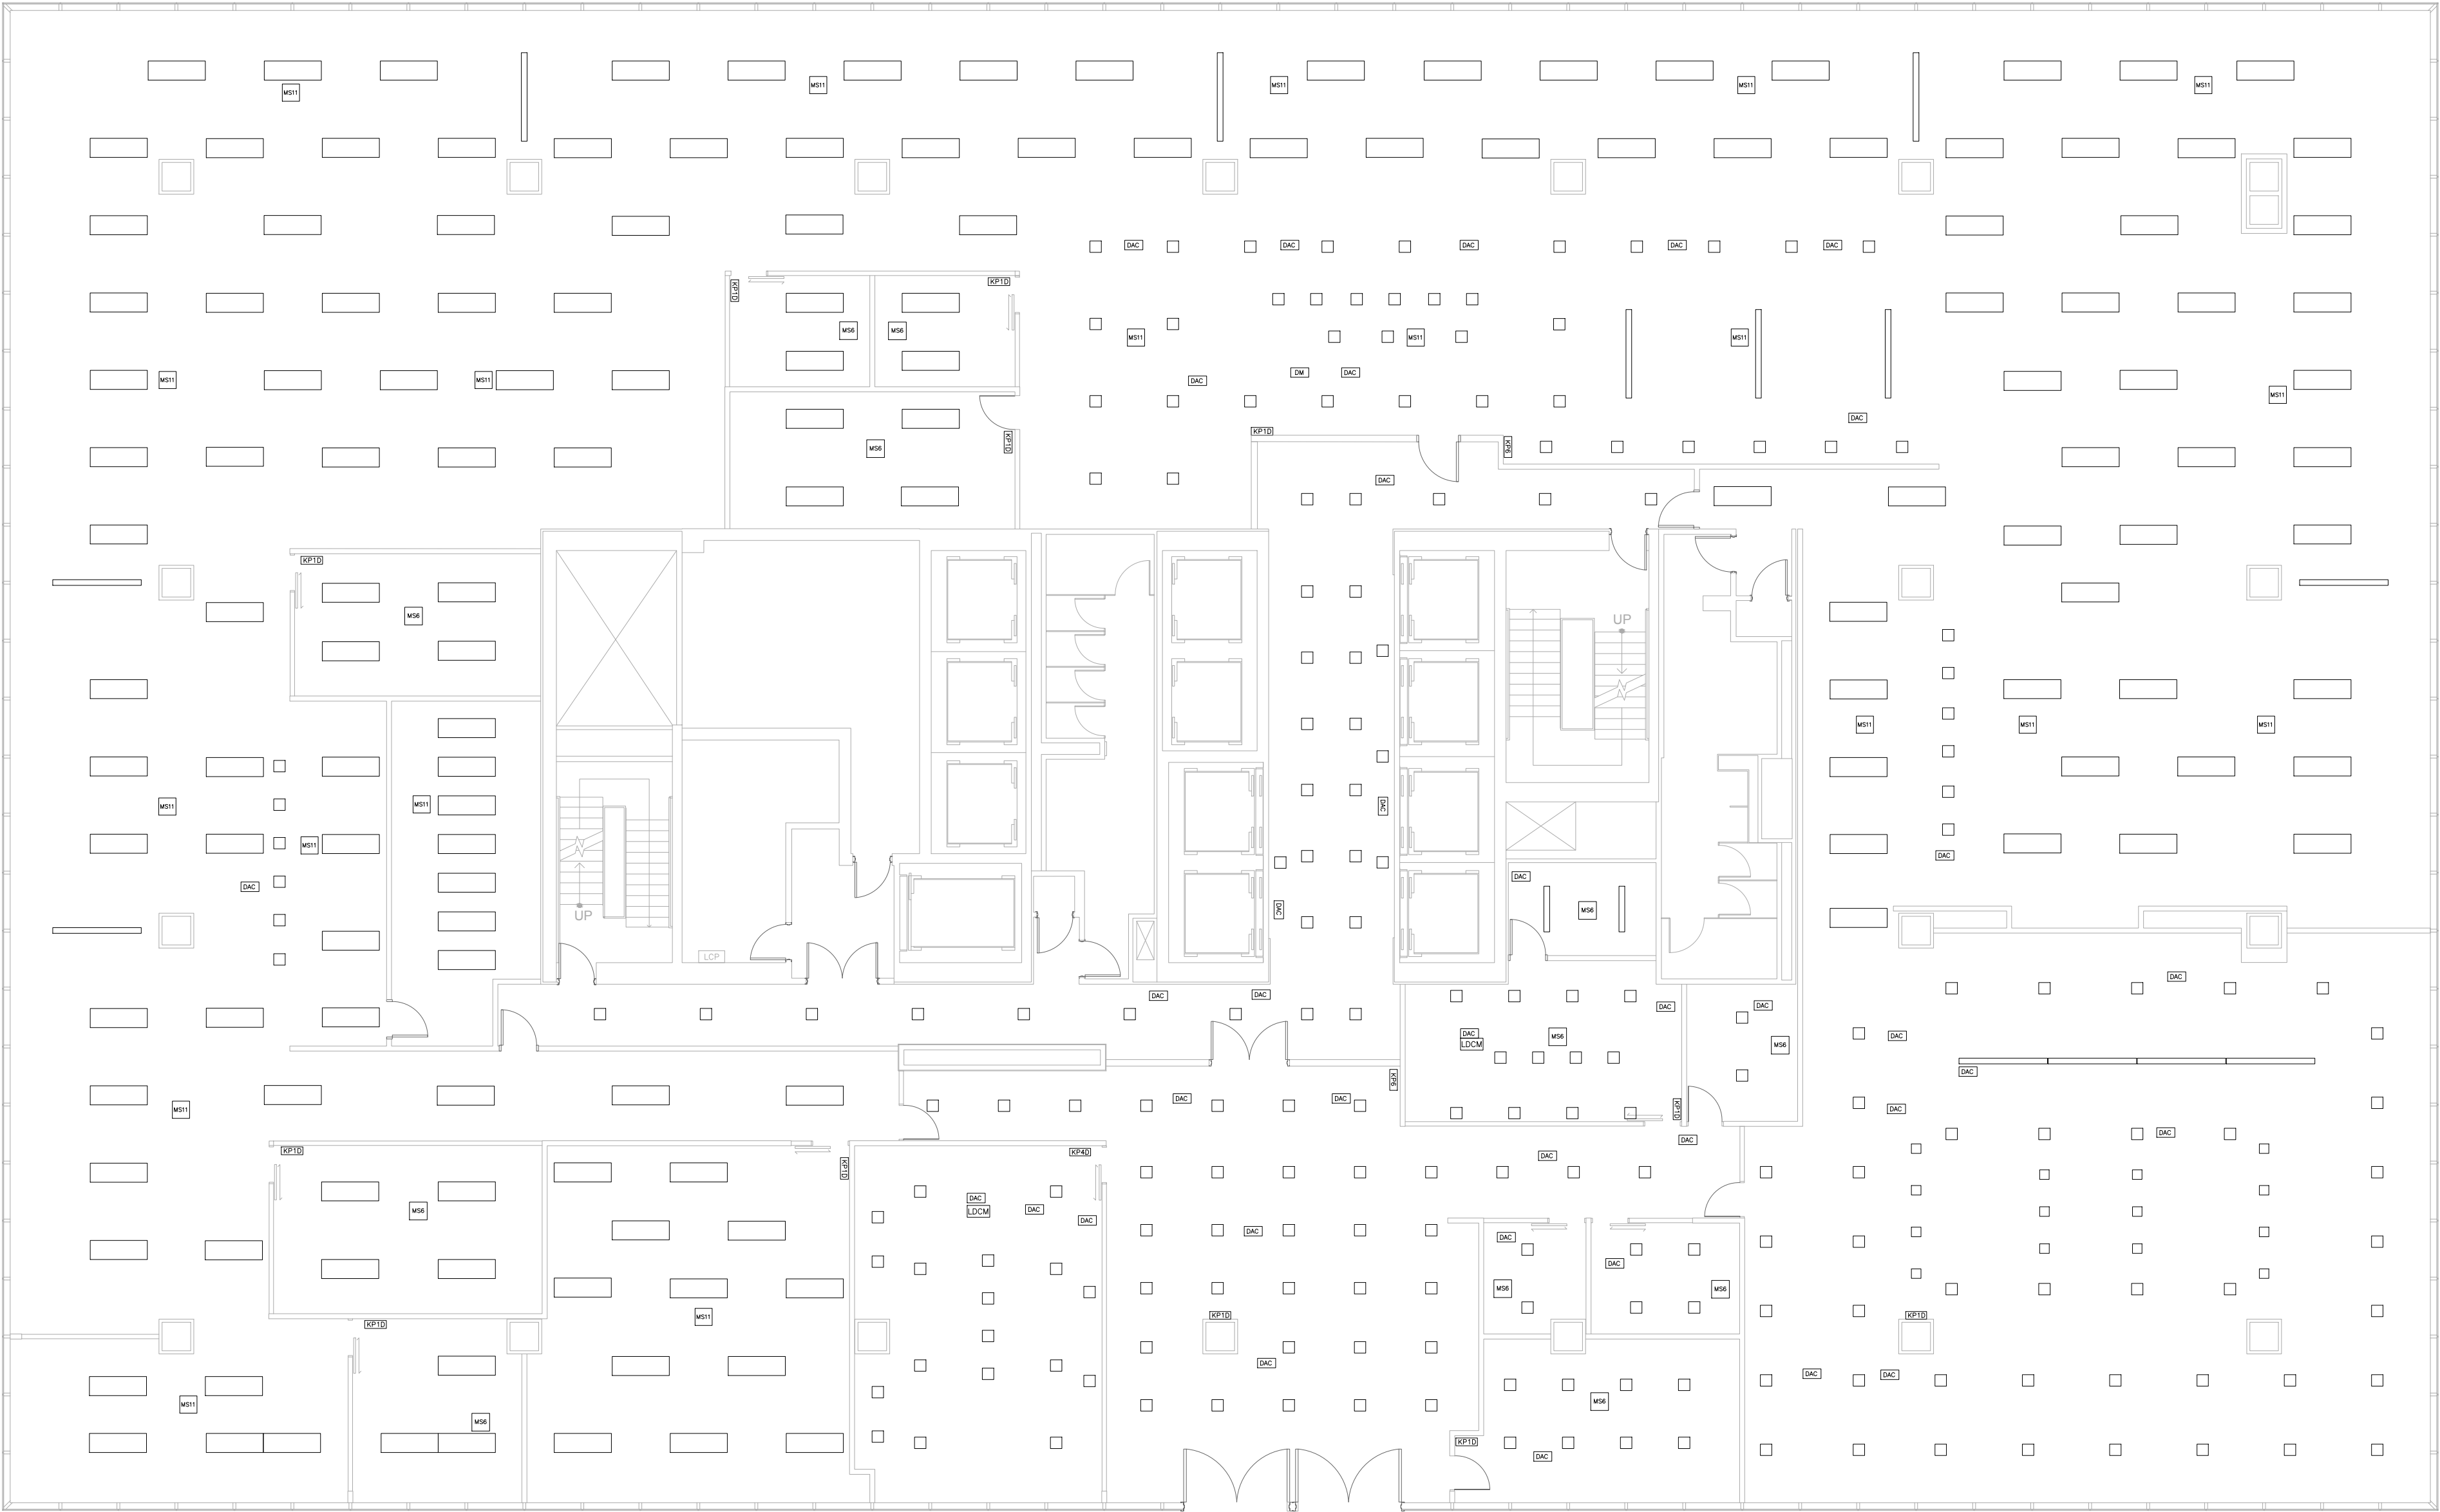

DATE	REV	DESCRIPTION	BY
12/10/2017	1	Initial Design	G.K.
12/10/2017	2	Revised Design	G.K.
12/10/2017	3	Final Design	G.K.
12/10/2017	4	As-Built	G.K.

JDRF
ELECTROMAG

THE INFORMATION ON THIS DRAWING IS THE PROPERTY OF JDRF CORPORATION. IT IS DISCLOSED IN CONFIDENCE AND IS NOT TO BE REPRODUCED, USED, OR DISCLOSED.

ABC BUILDING
Main Floor

TITLE: DALI LIGHTING SYSTEM		
DRAWN: G.K.	DATE: 12/10/2017	PROJ: #
DESIGNED: NTS	SCALE: NTS	DWG #: #
APPR: #	SHEET: 1/1	
	SIZE: C	